

Rural Work Order Cover Sheet

RAM Transaction #: 611594

Year: 24 - 25

Account Numbers Involved: 654483 609503, 564483

Sequence #1: SEGREGATION BY REQUEST - 609503 SEGREGATED OUT OF 564483 - SEGREGATION DONE ALONG EXISTING LOT LINES -1.97

Sequence #2: SEGREGATION BY REQUEST - 609503 SEGREGATED OUT OF 564483 - SEGREGATION DONE ALONG EXISTING LOT LINES +1.97

Sequence #3: _____

Sequence #4: _____

Sequence #5: _____

Check For:					Forms Included:	
	Yes	No		Yes	No	✓
Move Building Permits	<input type="checkbox"/>	<input checked="" type="checkbox"/>	Fire Patrol (Email Supervisor)	<input type="checkbox"/>	<input checked="" type="checkbox"/>	RAM Report <input checked="" type="checkbox"/>
Move Photos	<input type="checkbox"/>	<input checked="" type="checkbox"/>	Multi-Section	<input type="checkbox"/>	<input checked="" type="checkbox"/>	Processing Forms <input checked="" type="checkbox"/>
Update Apex	<input type="checkbox"/>	<input checked="" type="checkbox"/>	Tagged for 2 nd year Reset	<input type="checkbox"/>	<input checked="" type="checkbox"/>	Before and After Maps <input checked="" type="checkbox"/>
Update Account Notes	<input checked="" type="checkbox"/>	<input type="checkbox"/>	Exemptions	<input type="checkbox"/>	<input checked="" type="checkbox"/>	Multi-Section Processing Form <input type="checkbox"/>
PAT LIAB	<input type="checkbox"/>	<input checked="" type="checkbox"/>	Update Tracker	<input type="checkbox"/>	<input type="checkbox"/>	Calculation Form(s) <input type="checkbox"/>

Miscellaneous Notes: _____

Appraiser: GRH Date: 05.09.24

Appraisal Review: WW Date: 5.13.24

Data Entry: Chris Date: 5/23/24

Tax Year	Account ID	Transaction	Voucher S#	Recorded Date	Cartog	Operation	Voucher Notes	Code	+/- Size	Size Type
2024	564483	611594	1	10/18/2023 0:00	SDB	SEGREGATION - FROM	SEGREGATION BY REQUEST - 609503 SEGREGATED OUT OF 564483 - SEGREGATION DONE ALONG EXISTING LOT LINES	5545	-1.97	A
2024	609503	611594	2	10/18/2023 0:00	SDB	SEGREGATION - TO	SEGREGATION BY REQUEST - 609503 SEGREGATED OUT OF 564483 - SEGREGATION DONE ALONG EXISTING LOT LINES	5545	1.97	A

Rural Work Order Processing Form

One Page Per Account

564483

Sequence #: 1 of 2 Account Number: MTL 091W18C000600 RAM Transaction ID: 611594

Type: COM LLA PPT SEG SUB AC R of W Vacate Map Maintenance

Account Details

Ma Sa Nh: 07 06 000 Prop Class: 550 RMV Class: 450

Assigned Appraiser: MATT LORD Part of Unit: Yes or No Fire Patrol: Yes or No

Land Fragment

Account From	Code Area	Liab Yr	Land Class	LUC	Value Source	# of Acres	Zone	Land Adjustments
564483	05545	1980	2BDSS	005	FARM USE - EFU	5.04	REST	GSOIL
564483	05545	1980	4BDSS	005	FARM USE - EFU	2.72	REST	

Total Acres: 7.76

Improvements

Account From	Code Area	Imp ID	Stat Class	Description	Account From	Code Area	Imp ID	Stat Class	Description

Adjustments: _____

Exception

New MAV: _____ Sys Calc No Change to MAV

Rural Work Order Processing Form

One Page Per Account

609503

Sequence #: 2 of 2 Account Number: MTL 091W18B002200 RAM Transaction ID: 611594

Type: COM LLA PPT SEG SUB AC R of W Vacate Map Maintenance

Account Details

Ma Sa Nh: 07 06 000 Prop Class: 550 RMV Class: 450

Assigned Appraiser: MATT LORD Part of Unit: Yes or No Fire Patrol: Yes or No

Land Fragment

Account From	Code Area	Liab Yr	Land Class	LUC	Value Source	# of Acres	Zone	Land Adjustments
564483	05545	1980	4BDSS	005	FARM USE- EFU	1.97	REST	

Total Acres: 1.97

Improvements

Account From	Code Area	Imp ID	Stat Class	Description	Account From	Code Area	Imp ID	Stat Class	Description

Adjustments: _____

Exception

New MAV: _____ Sys Calc No Change to MAV

Before

09 1W 18C



MARION COUNTY, OREGON
SW1/4 SEC 18 T9S R1W W.M.
SCALE 1" = 200'

LEGEND

- LINE TYPES**
- Tonlot Boundary
 - Road Right-of-Way
 - Railroad Right-of-Way
 - Private Hoop ROW
 - Subdivision/Plat Boundary
 - Waterline - Toilet Brushy
 - Waterline - Non Brushy
 - Historical Boundary
 - Easement
 - Railroad Centerline
 - Taxcode Line
 - Map Boundary
 - Waterline - Non Brushy
- CORNER TYPES**
- + 1/16TH Section Cor
 - ⊕ 1/4 Section Cor
 - ⊙ D/C Corner
 - ⊕ 16' 15" Section Corner
 - ⊕ 21' 22" Section Corner
- NUMBERS**
- Tax Code Number
 - 00 00 00

All acres listed are Net Acres, excluding any portions of the plat within public ROWs

NOTES

Tick Marks: A tick mark in the road indicates that the labeled dimension extends into the public ROW.

CANCELLED NUMBERS

700
1000
1100


DISCLAIMER: THIS MAP WAS PREPARED FOR ASSESSMENT PURPOSES ONLY



FOR ADDITIONAL MAPS VISIT OUR WEBSITE AT www.co.marion.or.us

PLOT DATE: 10/17/2020

09 1W 18C

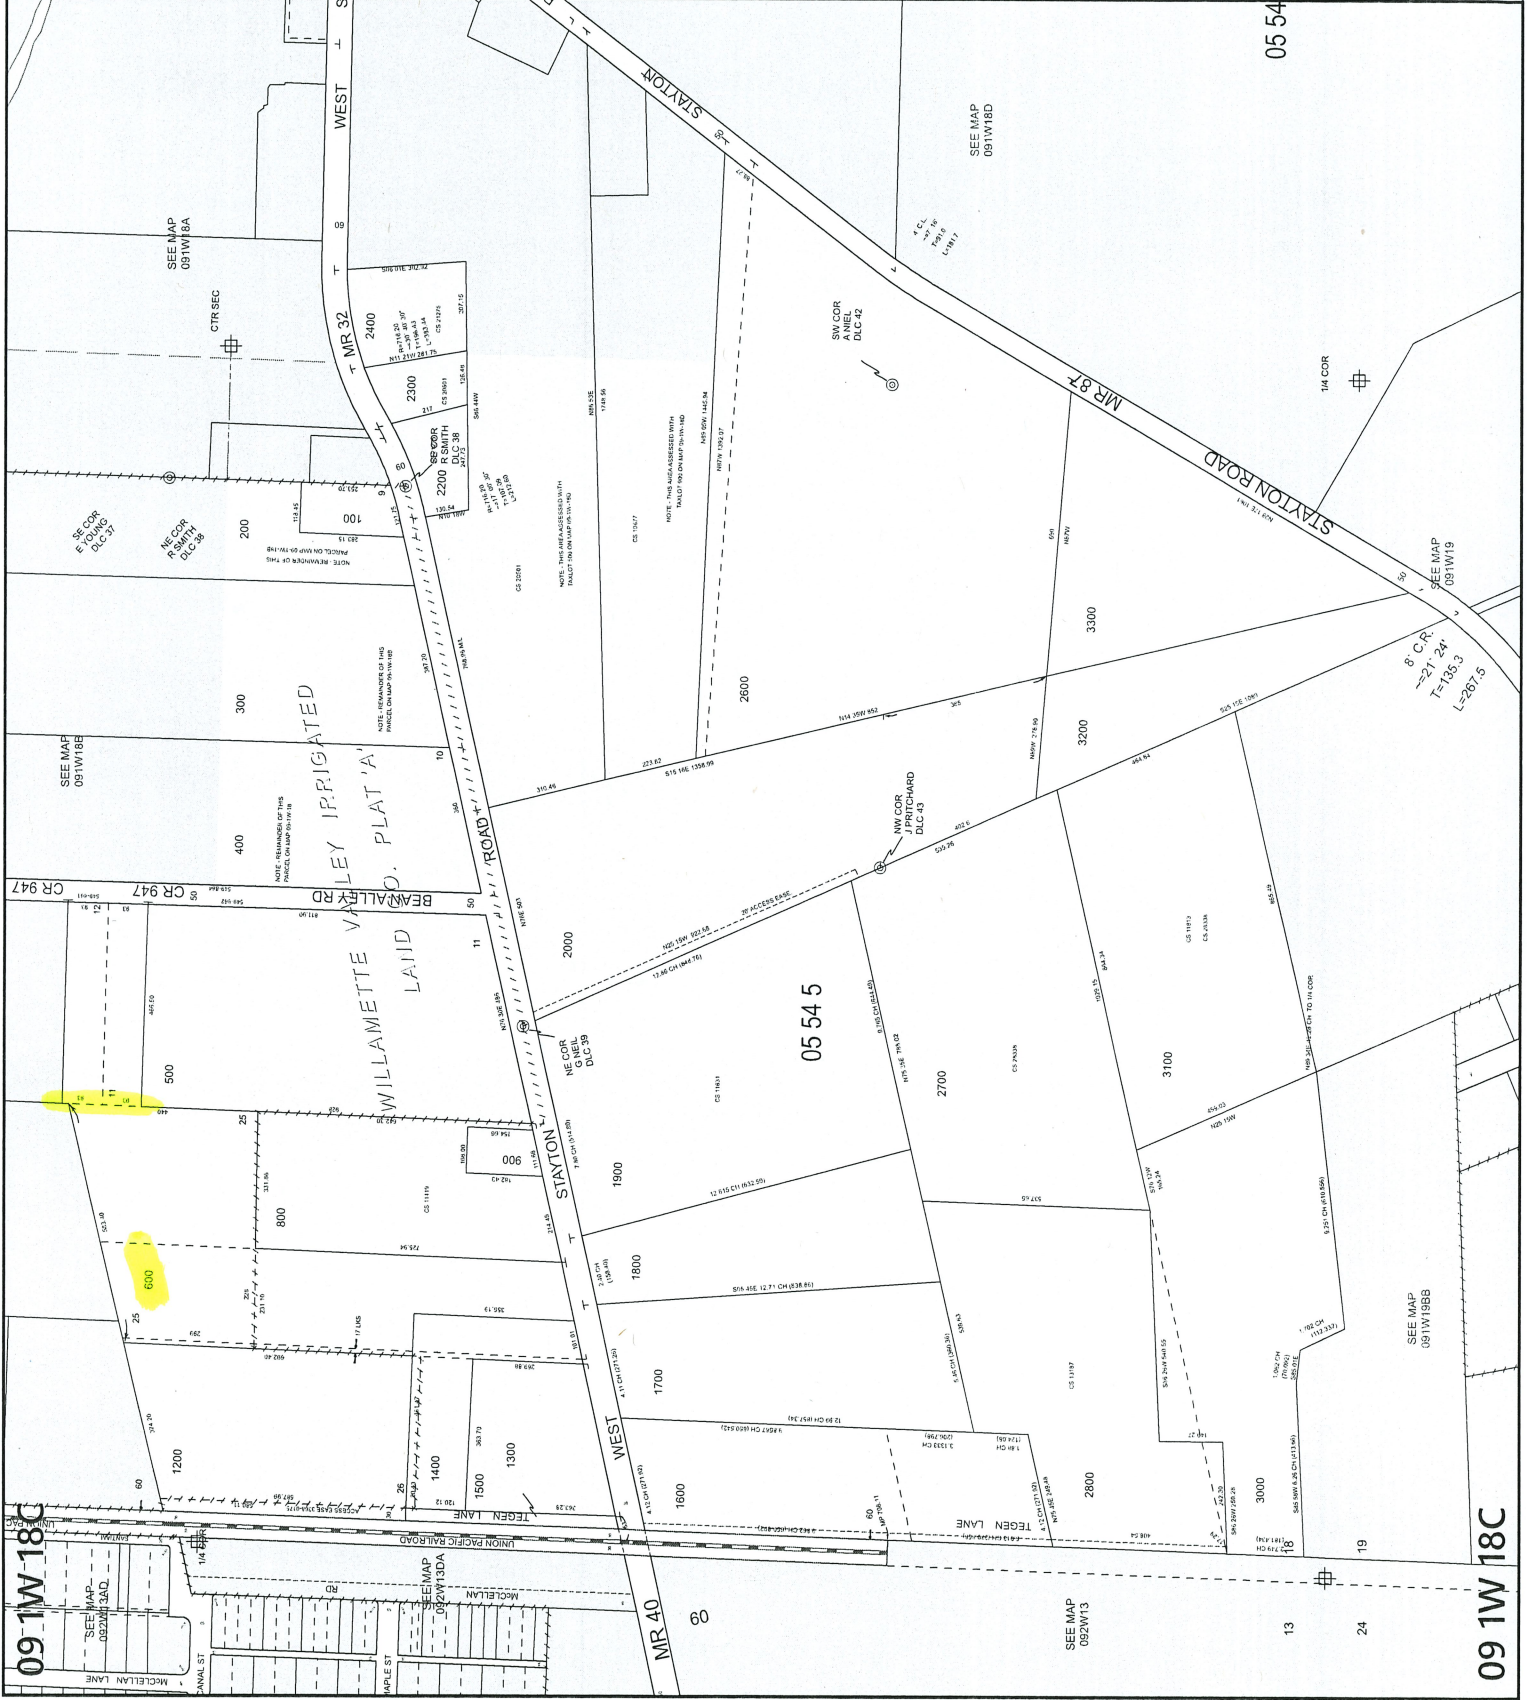

09 1W 18C

09 1W 18C

BEAN

09 1W 18B



MARION COUNTY, OREGON
NW1/4 SEC 18 T9S R1W W.M.
SCALE 1" = 200'

LEGEND

- LINE TYPES**
- Taxlot Boundary
 - Road Right-of-Way
 - Railroad Right-of-Way
 - Private Road ROW
 - Subdivision/Plat Boundary
 - Waterline - Taxlot Boundary
 - Waterline - Non Brady
 - Historical Boundary
 - Easement
 - Railroad Centerline
 - Escrow Line
 - Map Boundary

- CORNER TYPES**
- + 1/16TH Section Cor.
 - ⊙ D.C. Corner
 - ⊕ 1/4 Section Cor.
 - ⊕ 16 15 Section Corner
 - ⊕ 21 22 Section Corner

NUMBERS
Tax Code Number
00000

All areas listed are Net Acres, excluding any portions of the parcel within public ROWs

NOTES
1. Red marks in the road indicates that the labeled dimension extends into the public ROW



CANCELLED NUMBERS


DISCLAIMER: THIS MAP WAS PREPARED FOR ASSESSMENT PURPOSES ONLY



FOR ADDITIONAL MAPS VISIT OUR WEBSITE AT www.comarion.org

PLOT DATE: 10/17/2020

09 1W 18B

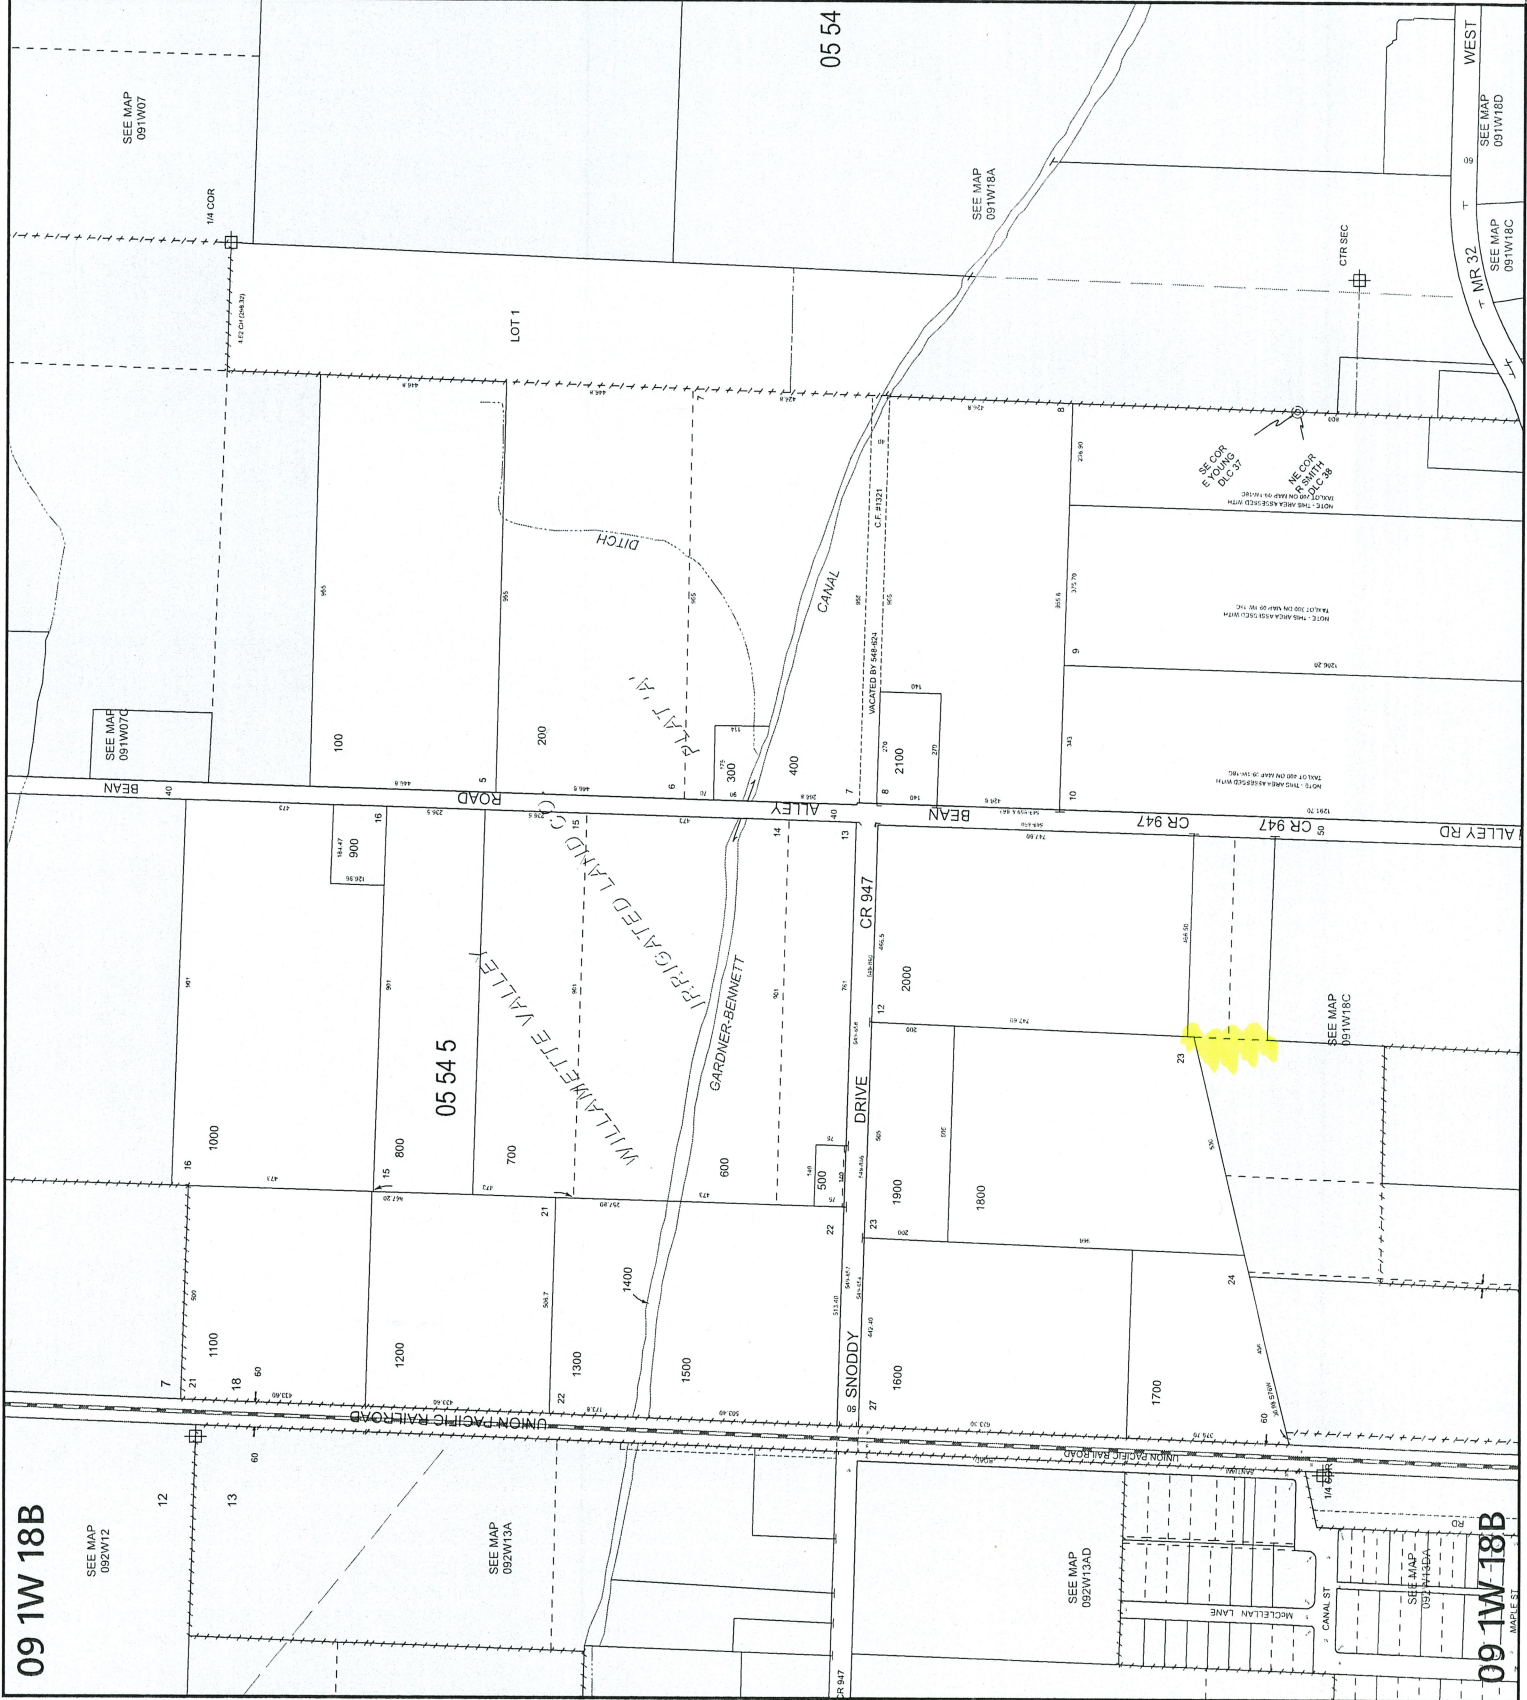

09 1W 18B

09 1W 18B

After

09 1W 18B



MARION COUNTY, OREGON
NW 1/4 SEC 18 T9S R1W W.M.
SCALE 1" = 200'

LEGEND

- LINE TYPES**
- Taxlot Boundary
 - Road Right-of-Way
 - Railroad Right-of-Way
 - Private Road ROW
 - Subdivision/Plat Boundary
 - Waterline - Taxlot Boundary
 - Waterline - Non Boundary
 - Historical Boundary
 - Easement
 - Railroad Centerline
 - Traverse Line
 - Map Boundary
- CORNER TYPES**
- + 1/16TH Section Cor.
 - ⊙ D.C. Corner
 - ⊕ 1/4 Section Cor.
 - ⊕ 16, 15 Section Corner
 - ⊕ 21, 22 Section Corner
- NUMBERS**
- Tax Code Number
 - 00000
- Acres**
- 0.29 AC
 - All acres listed are Net Acres, excluding any portions of the taxlot within public ROWs

NOTES
Tie Marks: A tick mark in the road indicates that the labeled dimension extends into the public ROW



CANCELLED NUMBERS


DISCLAIMER: THIS MAP WAS PREPARED FOR ASSESSMENT PURPOSES ONLY



FOR ADDITIONAL MAPS VISIT OUR WEBSITE AT www.co.marion.or.us

PLOT DATE: 4/26/2024

09 1W 18B

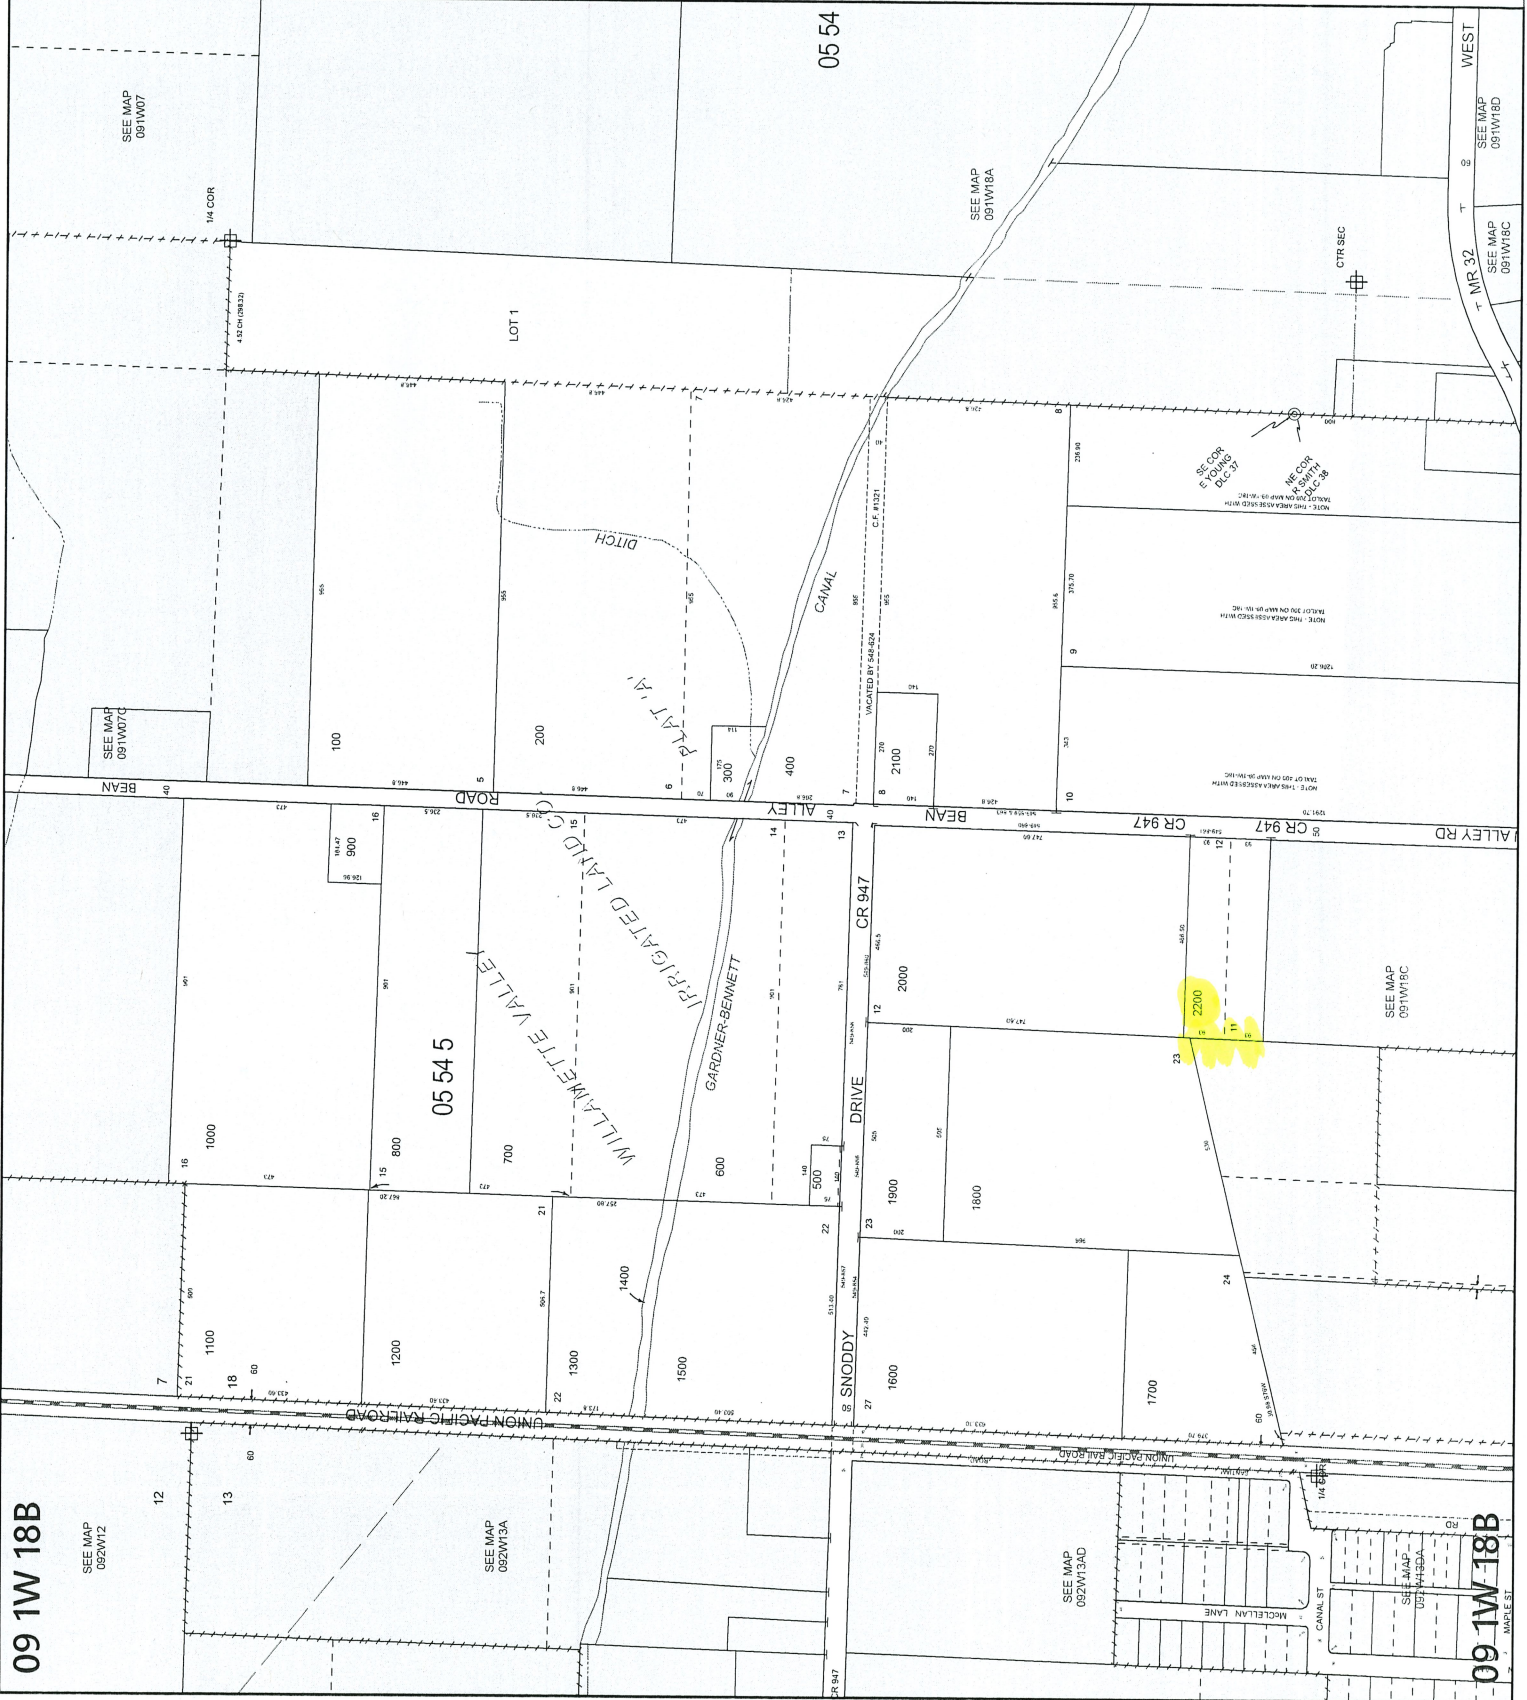

09 1W 18B

09 1W 18B